


# Lakeview Cemetery Map

NOTE: - Original Tracing made in 1935. This copy made from blueprint of original which has been lost from files. Changes from original in subdivisions 1, 2 and 4 have been made as shown. July 1939.

Sections III, V, 7, 7A, Muslim and New North Outline were added (see separate maps). Section VI has been designed but not yet surveyed.

Monument Section I was originally designed to fill the area now filled by Single Section 1 to the east (see separate map), which is why the lot numbering starts with Lot 514.

Lots 1-23 in Section S were never sold because a greenhouse was built in that location.

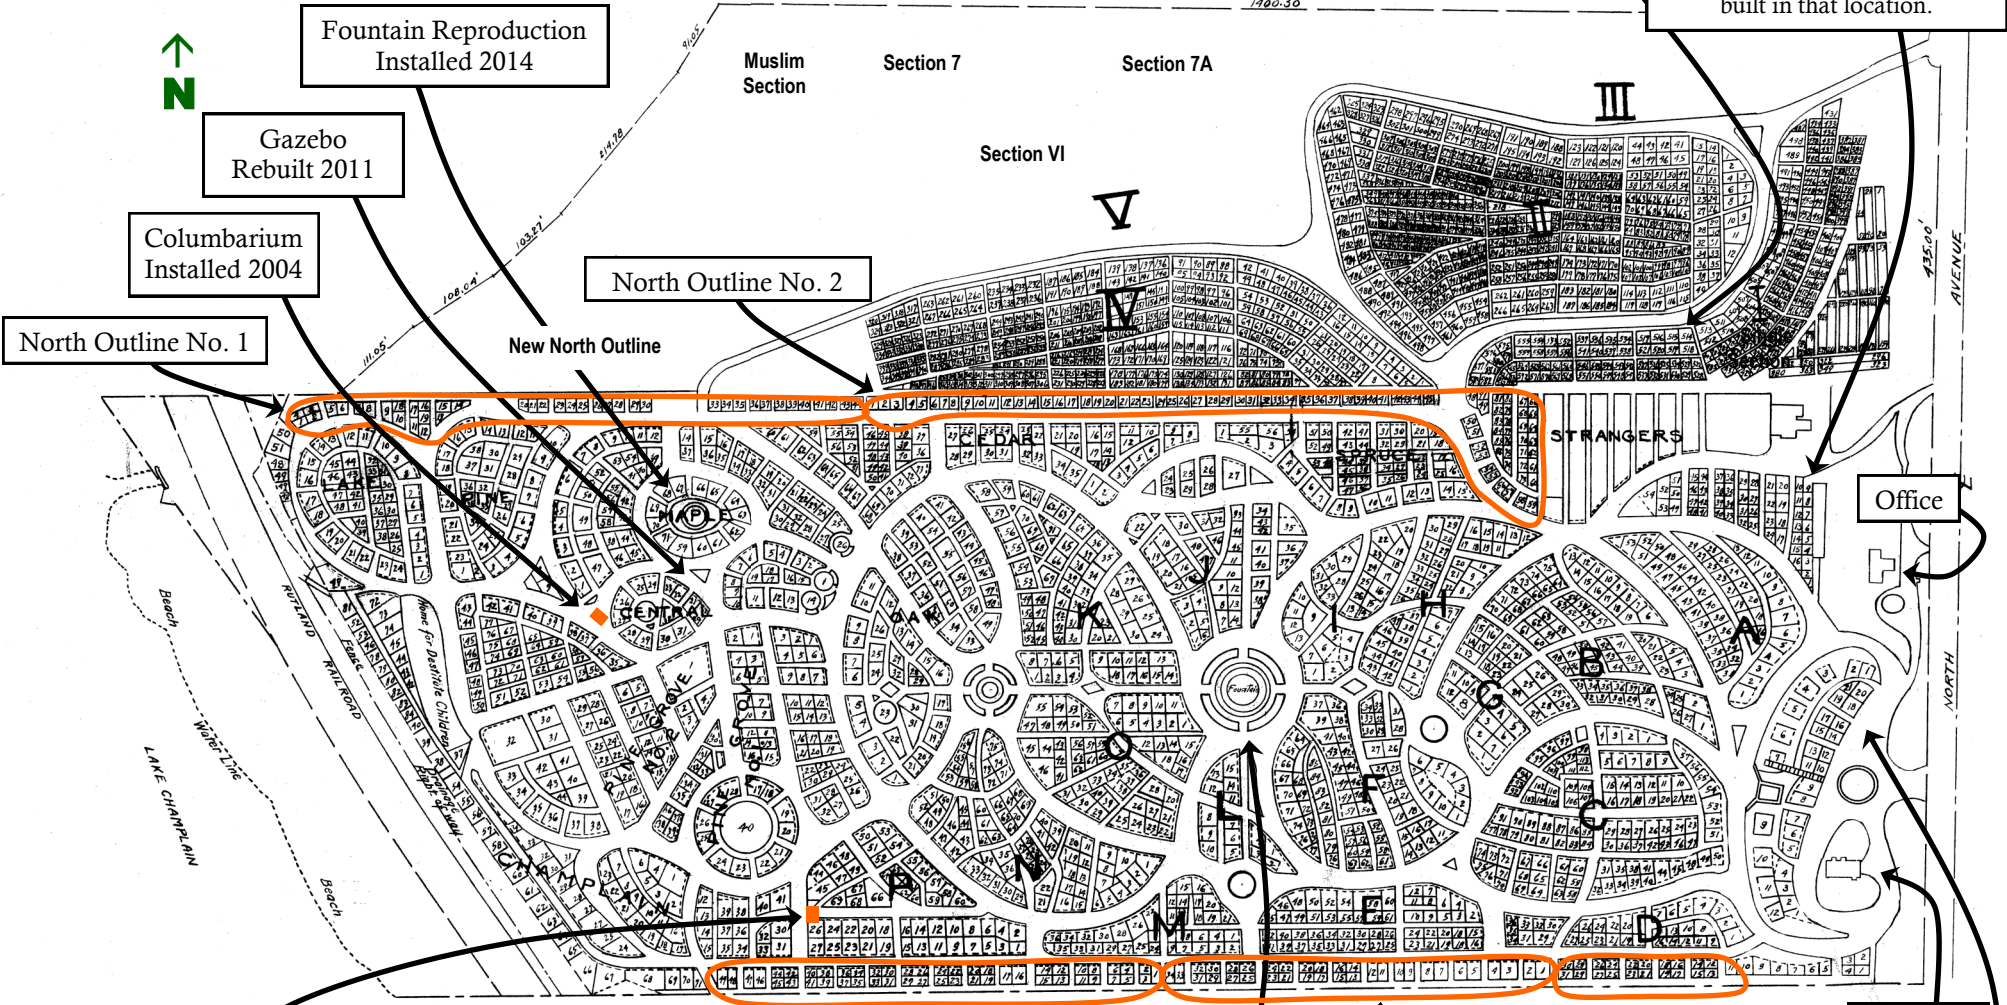

Fountain Reproduction Installed 2014

Gazebo Rebuilt 2011

Columbarium Installed 2004

North Outline No. 1

North Outline No. 2

New North Outline

Office

South Columbarium Installed 2014

South Outline No. 3

Fountain north of Section L Filled with earth, central monument installed to become the Howard Cremation Garden.

South Outline No. 2

South Outline No. 1 Lots 1-10 not sold.

Louisa Howard Chapel Restored 2006

Lots 1-17 in Summit Section not sold.

LAKEVIEW CEMETERY  
BURLINGTON VERMONT.

COPY OF ORIGINAL PLAN OF LAKEVIEW CEMETERY WITH CERTAIN CHANGES & CORRECTIONS BY MCINTOSH & CRANDALL 1916 ALSO NEW ADDITION 1922 AND SUBDIVISION OF ADDITION 1936  
*Geo. C. Stanley* CITY ENGINEER  
SCALE 1"=100'